

ALTA/NSPS & AS-BUILT SURVEY

POCAHONTAS, IL

Year: 2019 & 2022

Contact: Patrice Boeher

Client: Glenwood Equities

Westmore Group, Inc.


1415 Elbridge Payne Rd, Suite 285

ALTA/NSPS Survey Cost: \$3,000

Chesterfield, MO 63017

As-Built Survey Cost: \$3,000

(636) 534-5900

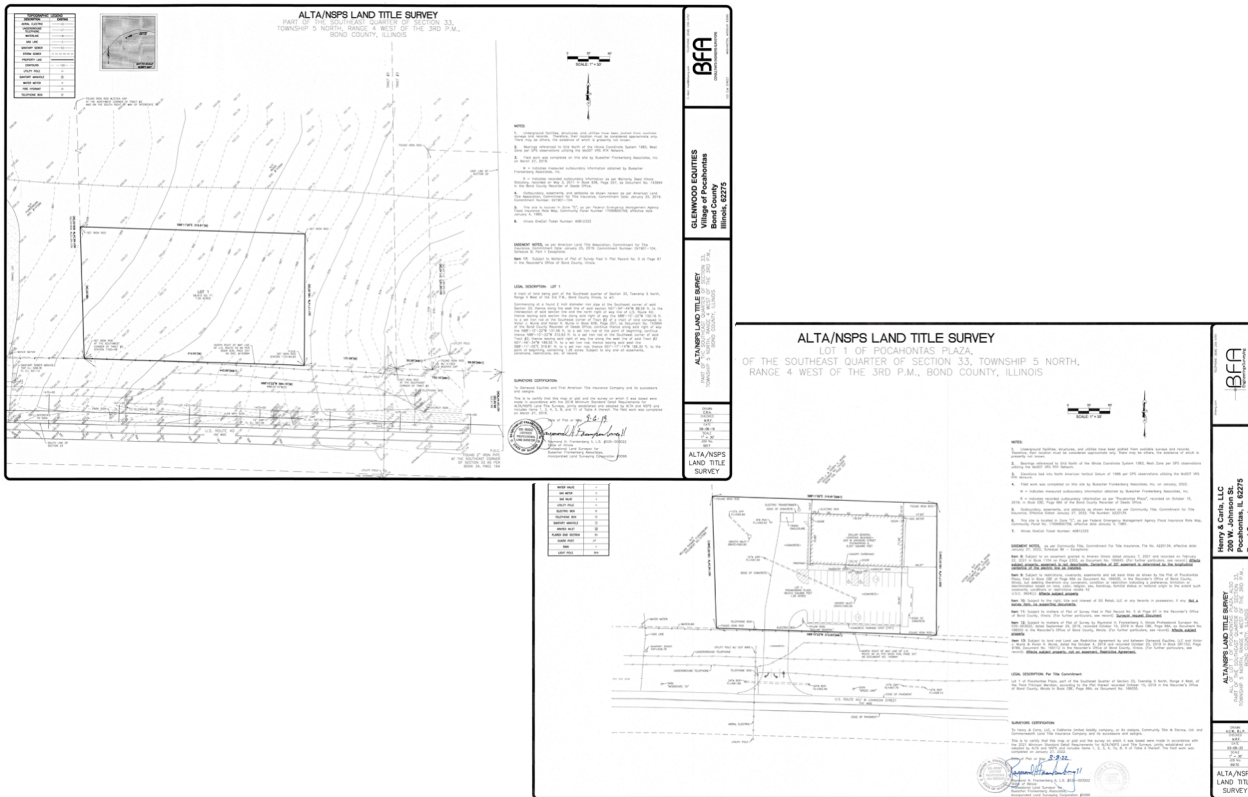

BFA created an original ALTA/NSPS and As-Built Survey for a Dollar General store in Pocahontas, IL. BFA did not handle any engineering work for this Dollar General store, however, BFA handled all of the surveying requirements.

Project Manager: Chase R. Hellebusch

Immediate Supervisor: Mark R. Frankenberg

BFA

ALTA/NSPS & AS-BUILT SURVEY